

DWG. TITLE:  
GROUND FLOOR PLAN  
AS BUILT FLOOR PLAN

◁ MAIN ROAD ▷


# EMERGENCY LIGHTING LAYOUT PLA

PREPARED BY:  
Bricks Construction Co

Client:  
IOM

PROJECT:  
Zainab Memorial Hospital  
Lahore



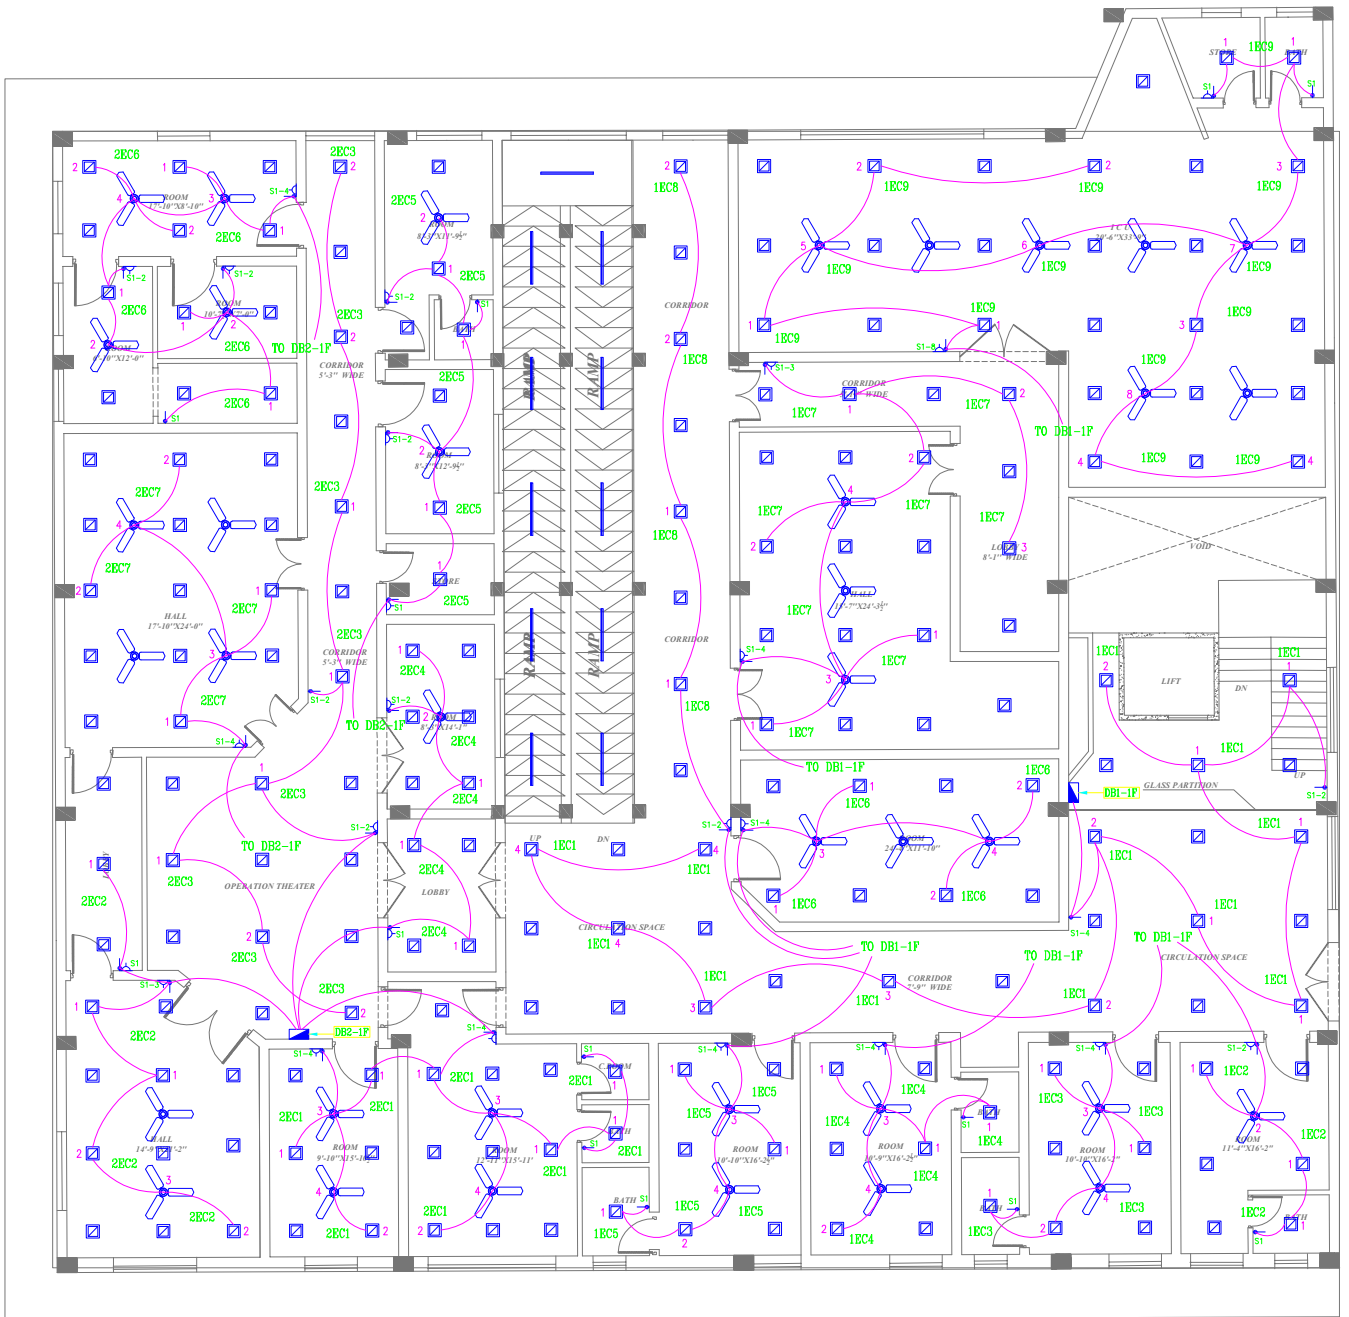

**DWG. TITLE:**  
**FIRST FLOOR PLAN**  
**AS BUILT FLOOR PLAN**

# EMERGENCY LIGHTING LAYOUT PLAN

**PREPARED BY:**

Bricks Construction Co


**Client:**

IOM

**PROJECT:**

Zainab Memorial Hospital  
 Lahore



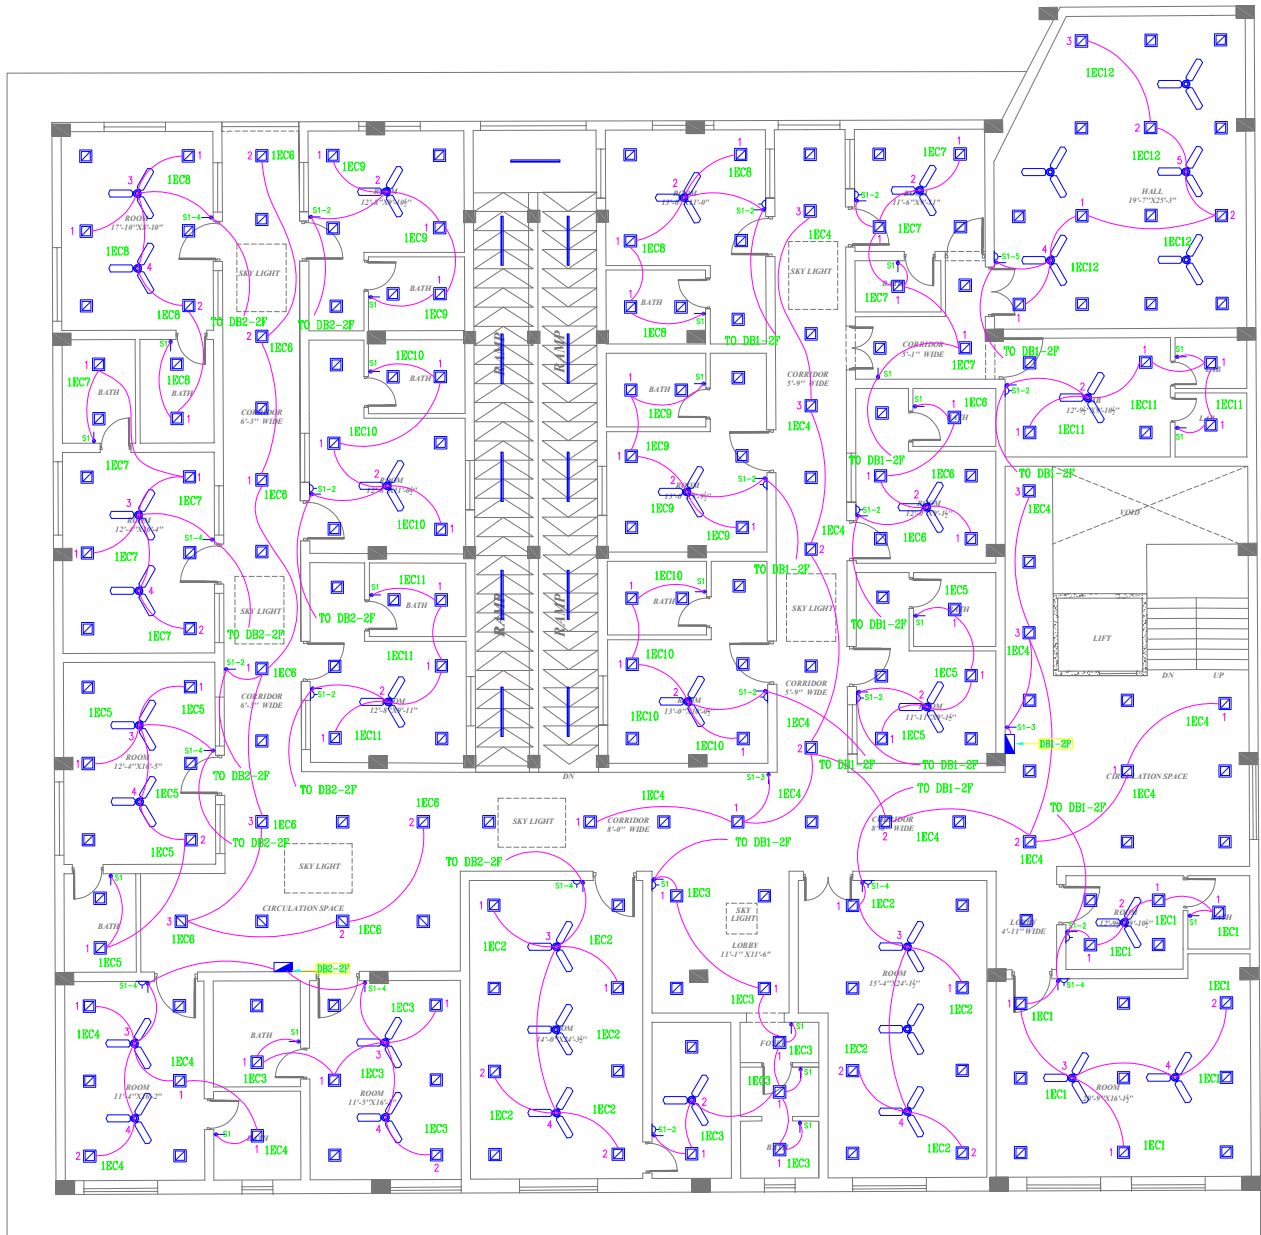

**DWG. TITLE:**  
**SECOND FLOOR PLAN**  
 AS BUILT FLOOR PLAN

# EMERGENCY LIGHTING LAYOUT PLAN

**PREPARED BY:**

Bricks Construction Co

**Client:**

IOM

**PROJECT:**

Zainab Memorial Hospital  
 Lahore

