
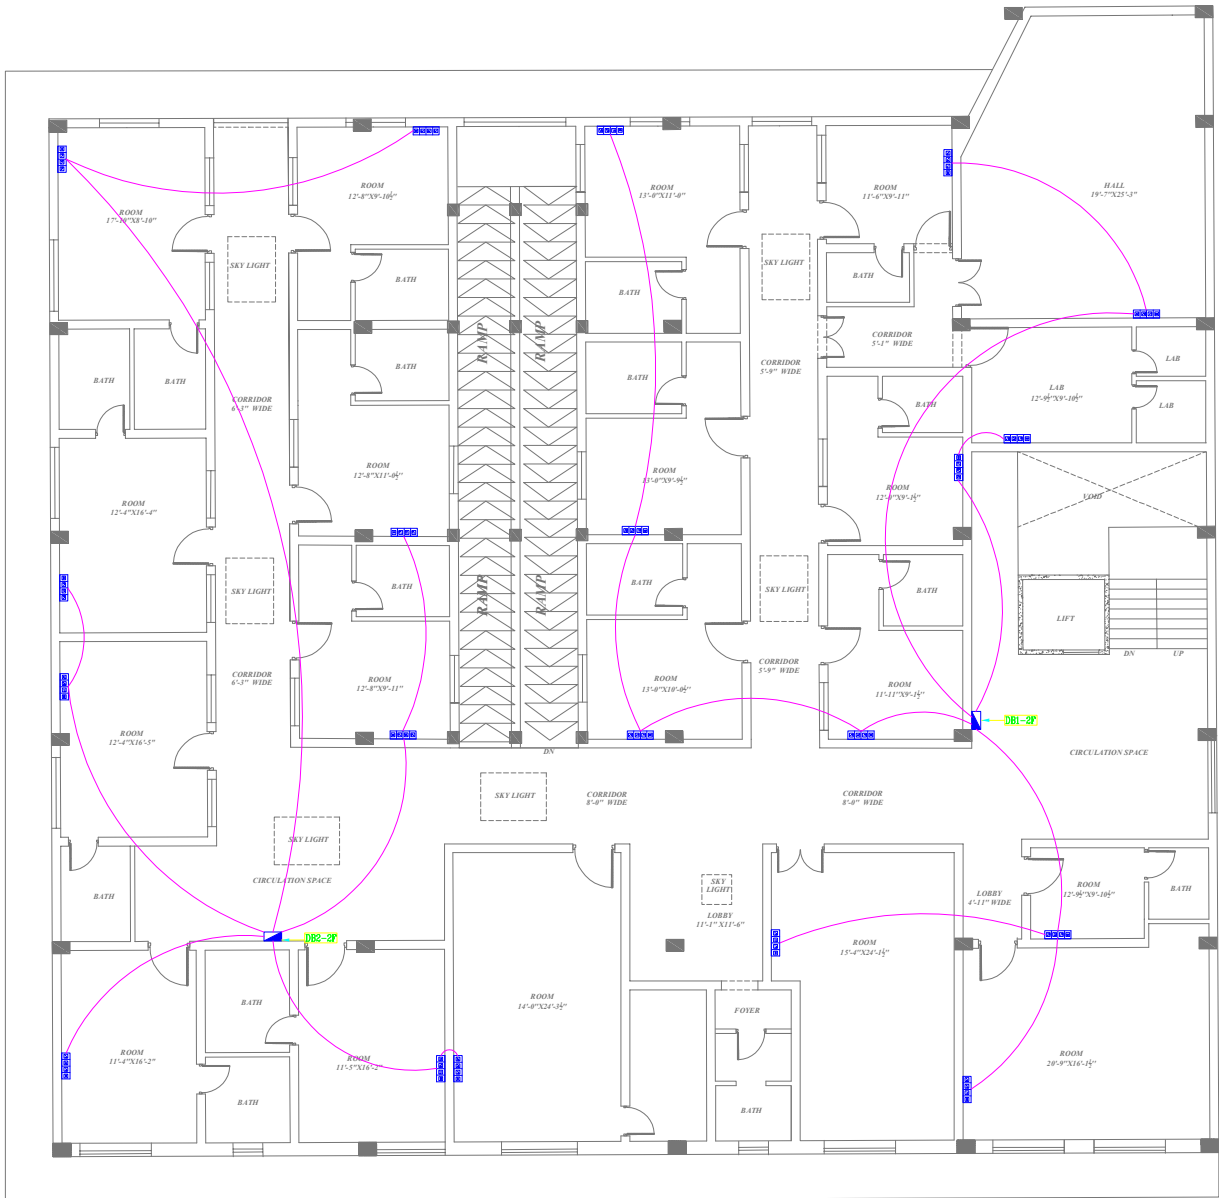


DWG. TITLE:
GROUND FLOOR PLAN
AS BUILT FLOOR PLAN

EMERGENCY POWER LAYOUT PLAN

<p>PREPARED BY: Bricks Construction Co</p>	<p>Client: IOM</p>	<p>PROJECT: Zainab Memorial Hospital Lahore</p>	
---	-------------------------------	--	---



DWG. TITLE:
SECOND FLOOR PLAN
AS BUILT FLOOR PLAN

EMERGENCY POWER LAYOUT PLAN

PREPARED BY:

Bricks Construction Co

Client:

IOM

PROJECT:

Zainab Memorial Hospital
 Lahore

