



DWG. TITLE:
GROUND FLOOR PLAN
AS BUILT FLOOR PLAN

◁ MAIN ROAD ▷


ILLUMINATION LAYOUT PLAN

PREPARED BY:
Bricks Construction Co

Client:
IOM

PROJECT:
Zainab Memorial Hospital
Lahore




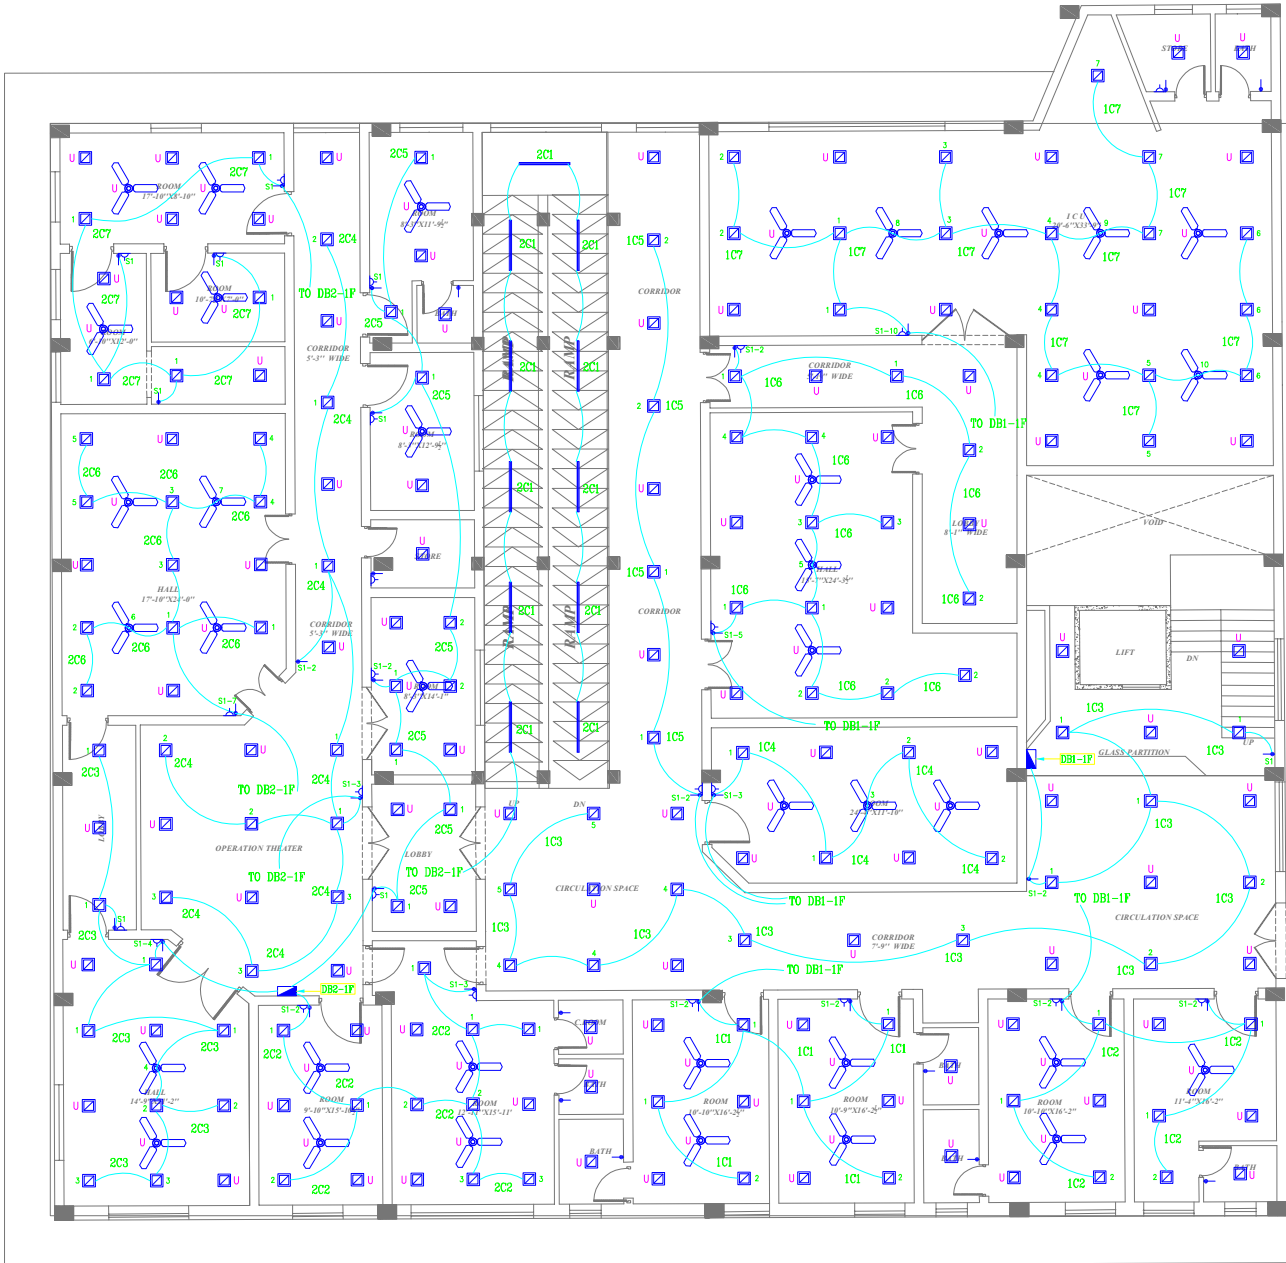

DWG. TITLE:
FIRST FLOOR PLAN
AS BUILT FLOOR PLAN

ILLUMINATION LAYOUT PLAN

<p>PREPARED BY: Bricks Construction Co</p>	<p>Client: IOM</p>	<p>PROJECT: Zainab Memorial Hospital Lahore</p>	
--	--	--	---

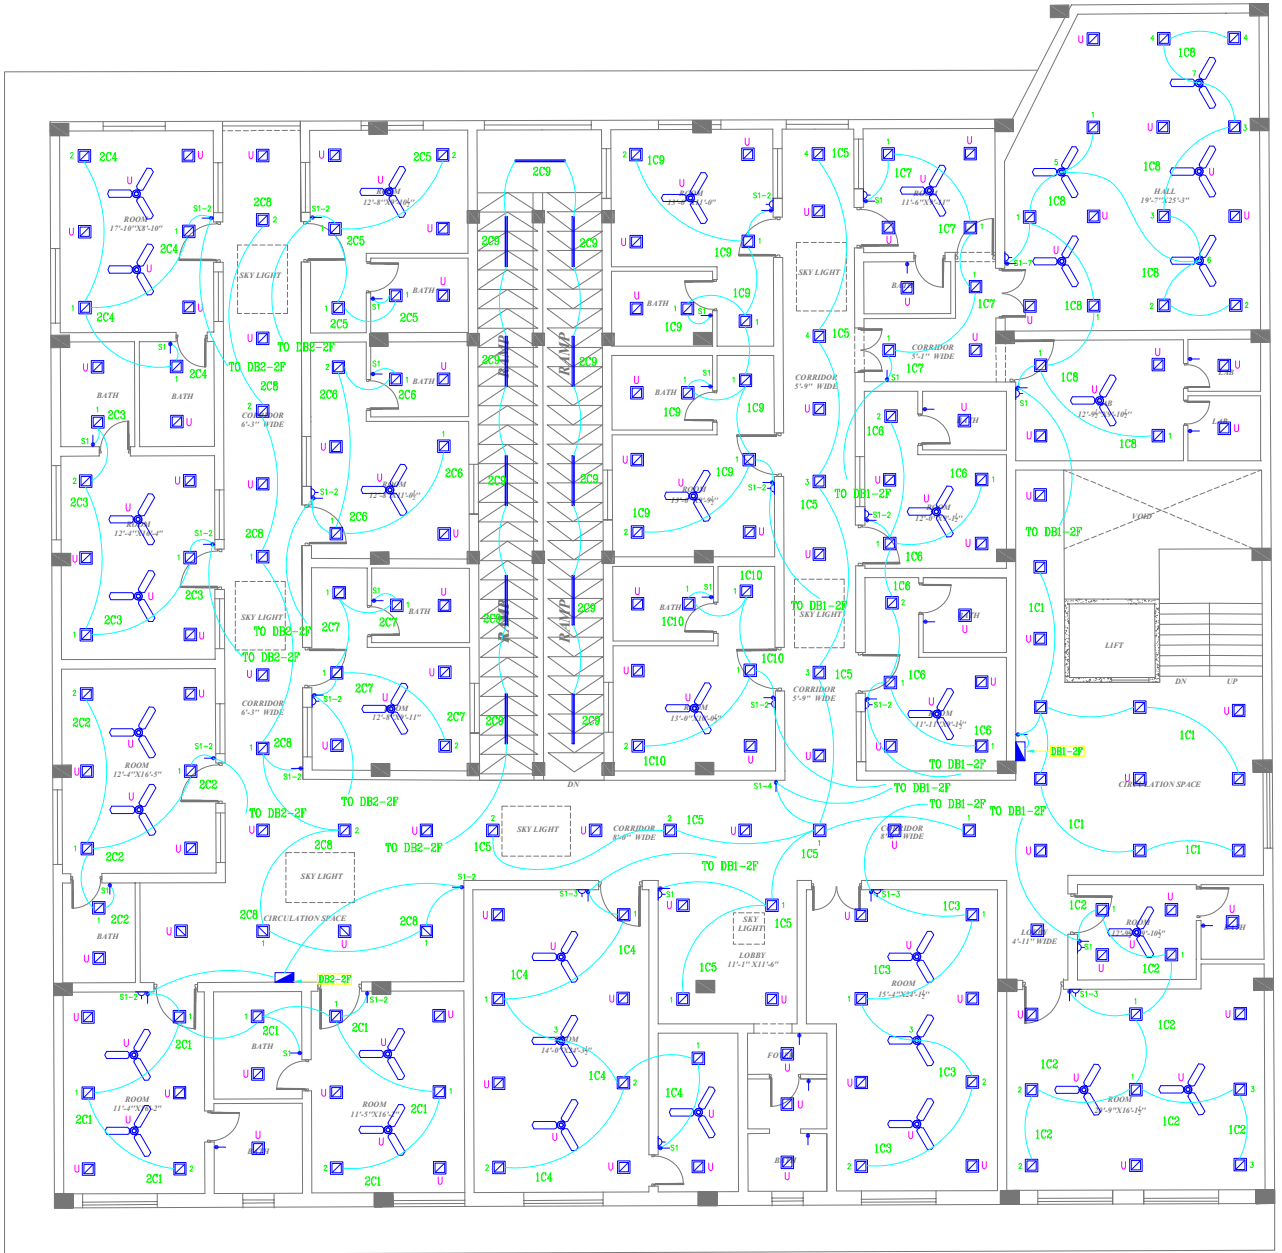

DWG. TITLE:
SECOND FLOOR PLAN
AS BUILT FLOOR PLAN

ILLUMINATION LAYOUT PLAN

PREPARED BY:
 Bricks Construction Co

Client:
 IOM

PROJECT:
 Zainab Memorial Hospital
 Lahore

