

**DWG. TITLE:**FIRST FLOOR PLAN
AS BUILT FLOOR PLAN

## PUBLIC ADDRESS SYSTEM LAYOUT PLAN

PREPARED BY:

Bricks Construction Co


Client:

IOM

PROJECT:

Zainab Memorial Hospital Lahore



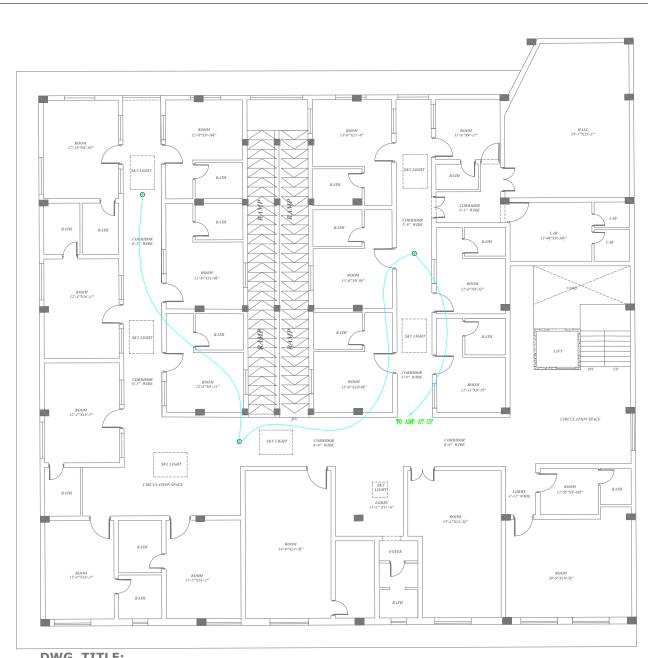

**DWG. TITLE:**SECOND FLOOR PLAN
AS BUILT FLOOR PLAN

## PUBLIC ADDRESS SYSTEM LAYOUT PLAN

PREPARED BY:

Bricks Construction Co

Client:
IOM

PROJECT:
Zainab Memorial Hospital
Lahore

Building Dreams