

DWG. TITLE:
GROUND FLOOR PLAN
AS BUILT FLOOR PLAN

◁ MAIN ROAD ▷


MATV SYSTEM LAYOUT PLAN

PREPARED BY:
Bricks Construction Co

Client:
IOM

PROJECT:
Zainab Memorial Hospital
Lahore



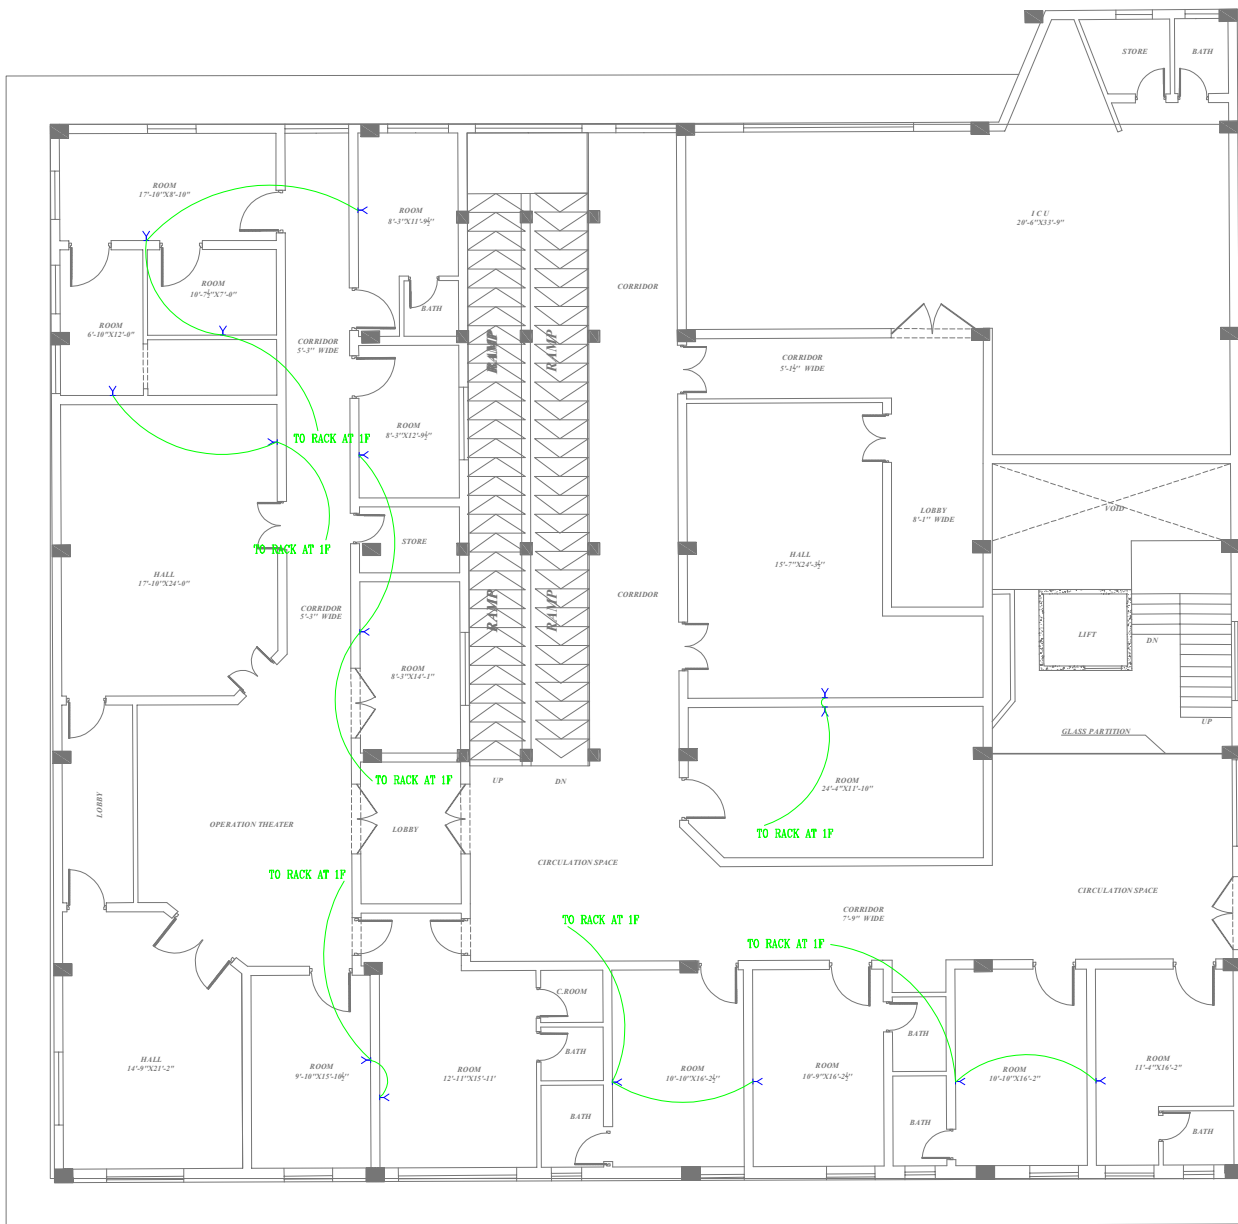

DWG. TITLE:
FIRST FLOOR PLAN
AS BUILT FLOOR PLAN

MATV SYSTEM LAYOUT PLAN

PREPARED BY:

Bricks Construction Co


Client:

IOM

PROJECT:

Zainab Memorial Hospital
 Lahore



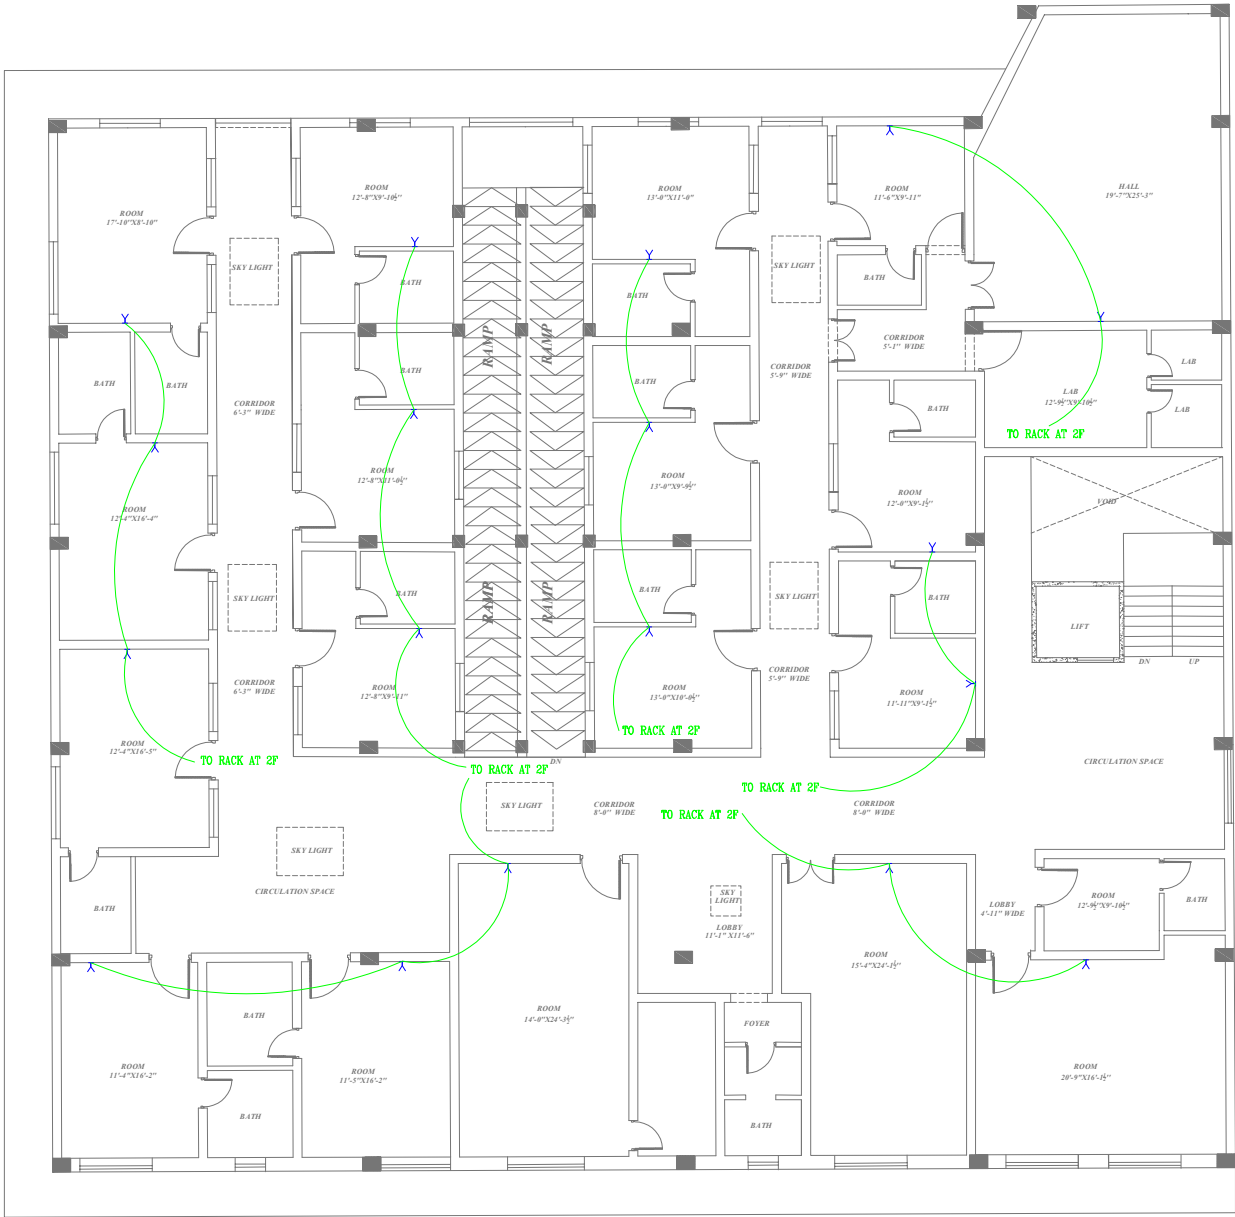

DWG. TITLE:
SECOND FLOOR PLAN
AS BUILT FLOOR PLAN

MATV SYSTEM LAYOUT PLAN

PREPARED BY:

Bricks Construction Co

Client:

IOM

PROJECT:

Zainab Memorial Hospital
Lahore

