

DWG. TITLE:
 GROUND FLOOR PLAN
 AS BUILT FLOOR PLAN

◁ MAIN ROAD ▷


RAW POWER LAYOUT PLAN

PREPARED BY:
 Bricks Construction Co

Client:
 IOM


PROJECT:
 Zainab Memorial Hospital
 Lahore



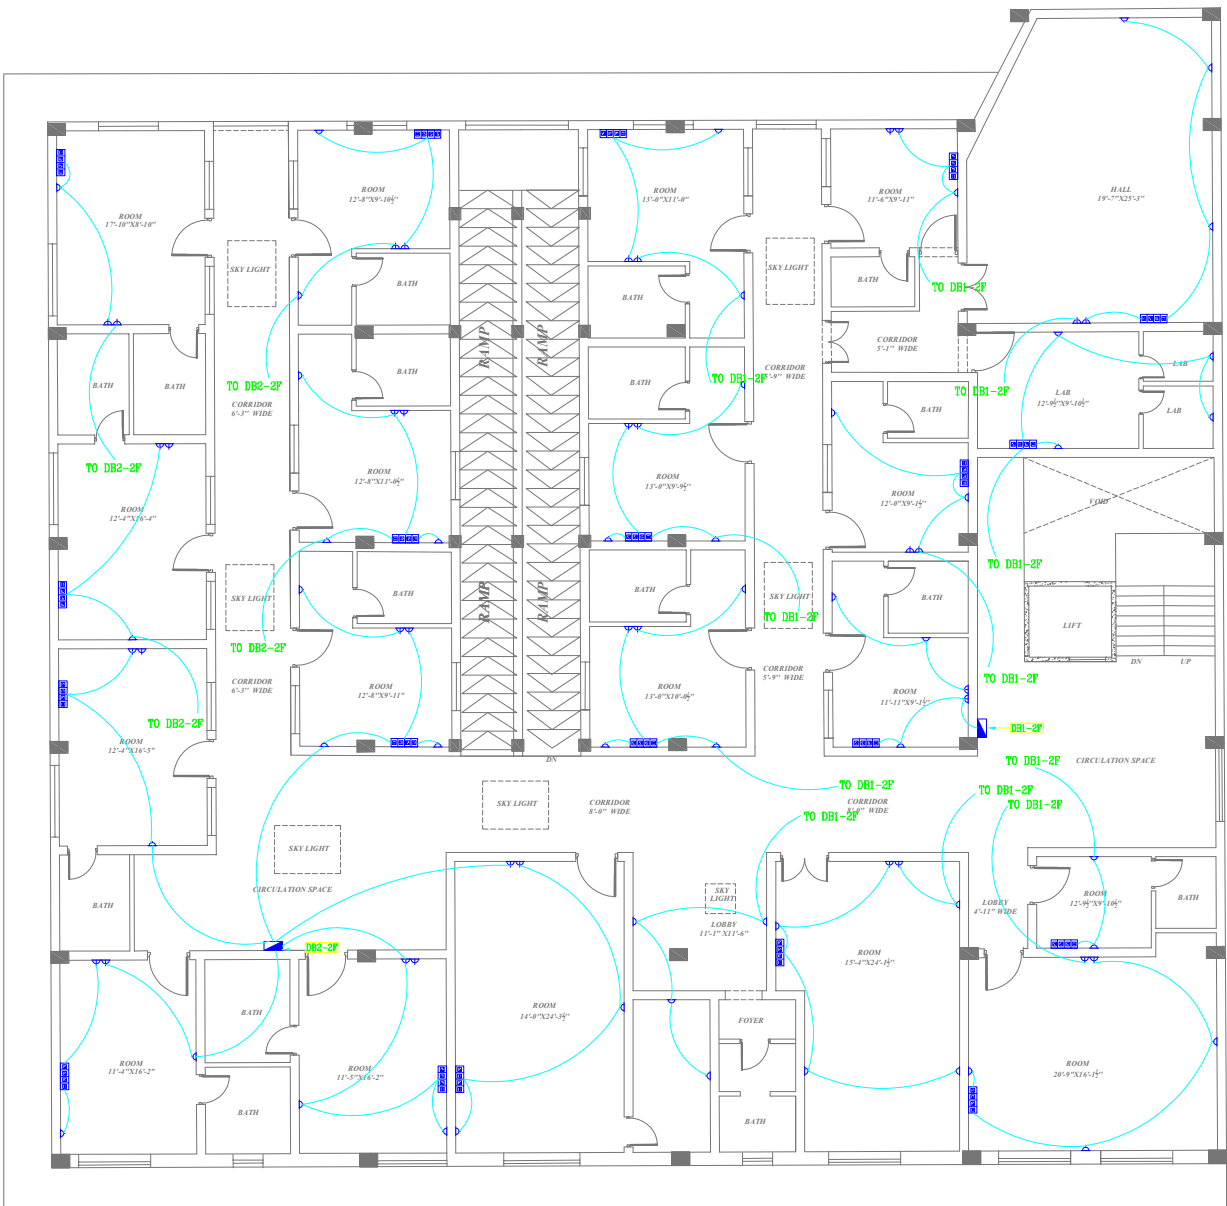

DWG. TITLE:
SECOND FLOOR PLAN
AS BUILT FLOOR PLAN

RAW POWER LAYOUT PLAN

<p>PREPARED BY: Bricks Construction Co</p>	<p>Client: IOM</p>	<p>PROJECT: Zainab Memorial Hospital Lahore</p>	
---	-------------------------------	--	---