


DWG. TITLE:
GROUND FLOOR PLAN
AS BUILT FLOOR PLAN

◁ MAIN ROAD ▷

TELEPHONE SYSTEM LAYOUT PLAN

<p>PREPARED BY: Bricks Construction Co</p>	<p>Client: IOM</p>	<p>PROJECT: Zainab Memorial Hospital Lahore</p>	
---	-------------------------------	--	--

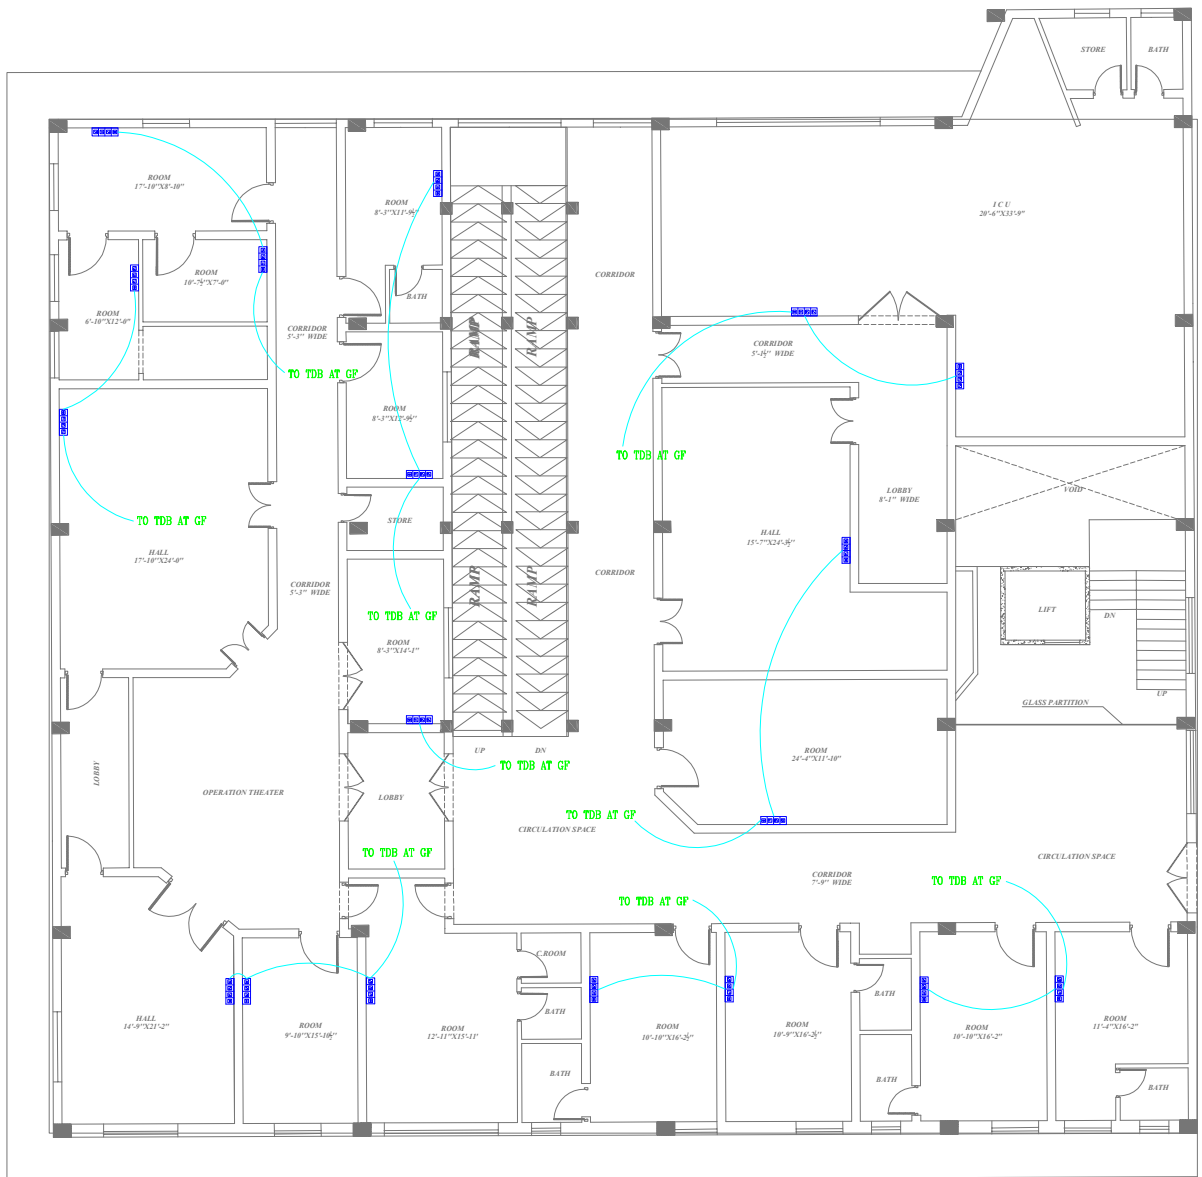

DWG. TITLE:
FIRST FLOOR PLAN
AS BUILT FLOOR PLAN

TELEPHONE SYSTEM LAYOUT PLAN

PREPARED BY:

Bricks Construction Co


Client:

IOM

PROJECT:

Zainab Memorial Hospital
 Lahore



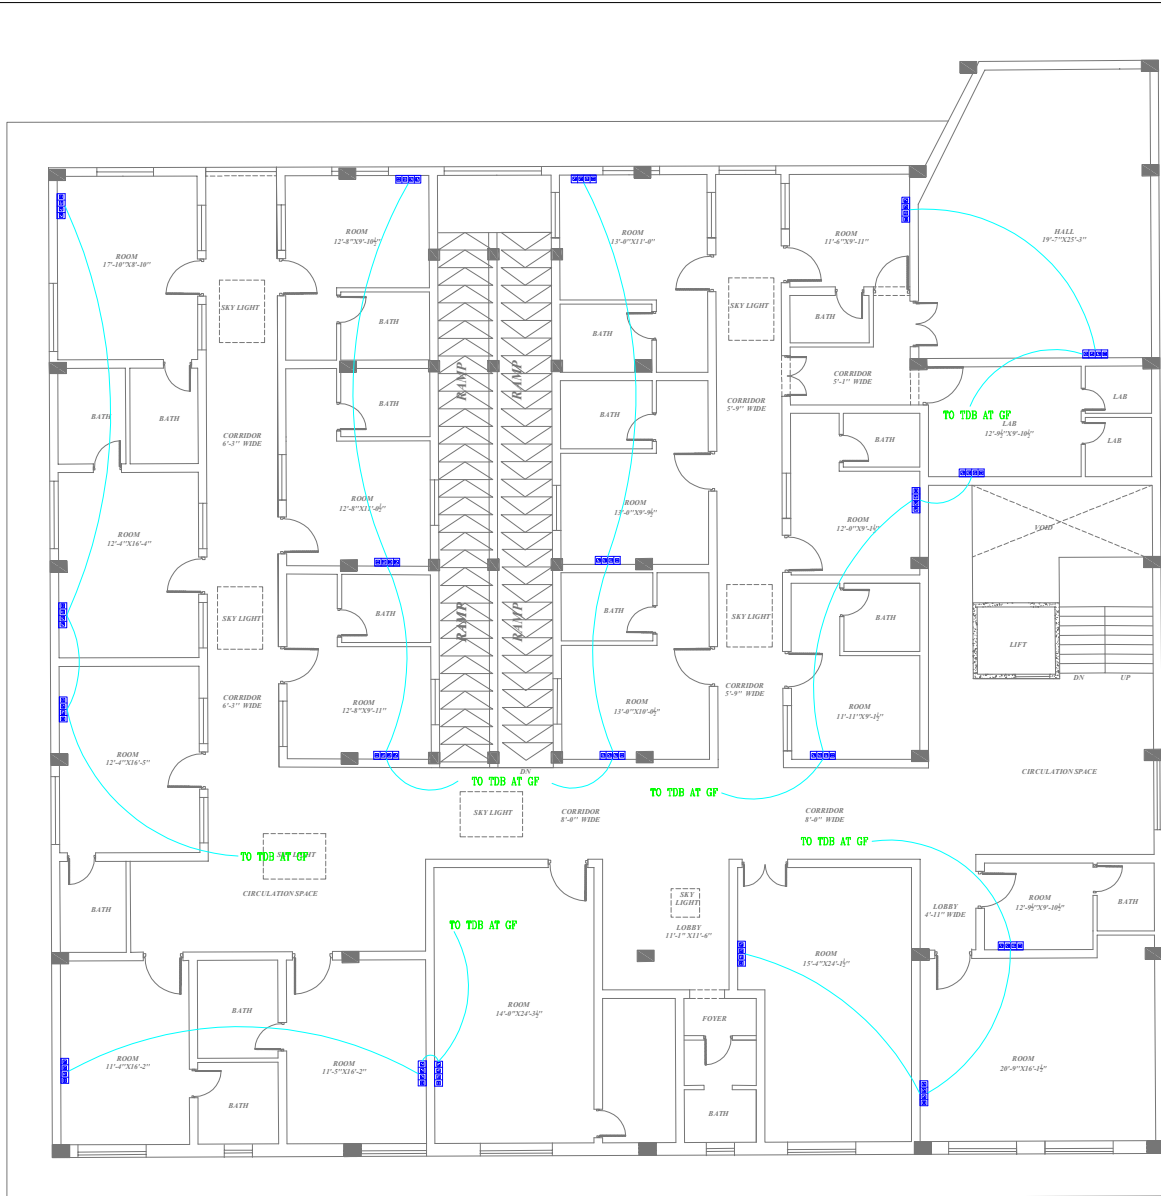

DWG. TITLE:
 SECOND FLOOR PLAN
 AS BUILT FLOOR PLAN

TELEPHONE SYSTEM LAYOUT PLAN

PREPARED BY:

Bricks Construction Co

Client:

ION

PROJECT:

Zainab Memorial Hospital
 Lahore

